

OTTAWA COUNTY ENGINEERS OFFICE

REFERENCE NO. 8-6-16-H
SOUTH QUARTER POST SEC. 8
BAY TWP.
SHEET 1 OF 1.

ROUTE: C-17 OAK HARBOR SOUTHEAST RD.

TOWNSHIP: BAY

SECTION: 8

T 6 NR 16 E.


PERSONNEL:
M. WITTMAN, P.S.
J. ALLEN

NORTHING:

EASTING:

DATE / WEATHER / TEMP:
JUNE 18, 2012
SUNNY - SW
93° F

DATUM:

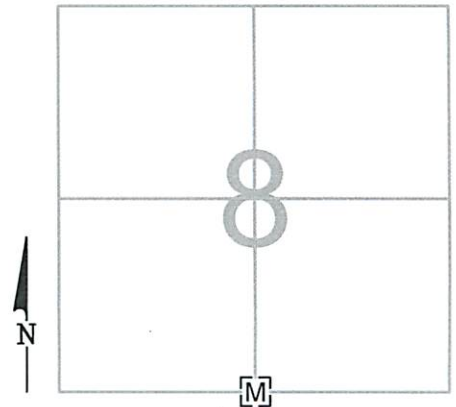

MONUMENT INFORMATION

MONUMENT TYPE: 1" SQ. IRON PIN IN MON BOX
ON SURFACE - BELOW: 0.30'
LEFT - CL PAV'T - RIGHT:



MISC. INFORMATION

