

OTTAWA COUNTY ENGINEERS OFFICE

REFERENCE NO. 8-6-16-U

S 1/4 POST SOUTHEAST 1/4 SEC. 25
BAY TWP.

SHEET 1 OF 1.

PERSONNEL:

M. WITTMAN, P.S.
J. ALLEN

DATE / WEATHER / TEMP:

JUNE 18, 2012
SUNNY - S-SW
92° F

ROUTE: C-17 OAK HARBOR SOUTHEAST RD.

TOWNSHIP: BAY


SECTION: 8

T 6 NR 16 E.

NORTHING:

EASTING:

DATUM:

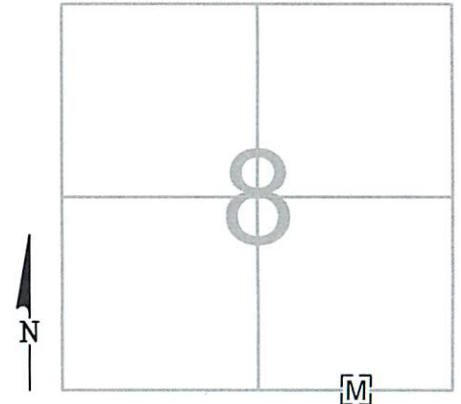

MONUMENT INFORMATION

MONUMENT TYPE: FD 1-1/4" SQ IRON PIN IN MON BOX
ON SURFACE - BELOW:
LEFT - CL PAV'T - RIGHT: 1.00'



MISC. INFORMATION

