

OTTAWA COUNTY ENGINEERS OFFICE

REFERENCE NO. 9-6-16-G
SOUTHWEST CORNER SEC. 9
BAY TWP.
SHEET 1 OF 1.

ROUTE: C-17 OAK HARBOR SOUTHEAST RD.

TOWNSHIP: BAY

SECTION: 9

T 6 NR 16 E.


PERSONNEL:
M. WITTMAN, P.S.
J. ALLEN

NORTHING:

EASTING:

DATE / WEATHER / TEMP:
JUNE 18, 2012
SUNNY - S
88° F

DATUM:

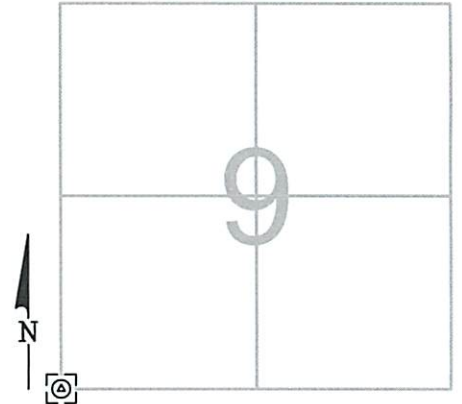

MONUMENT INFORMATION

MONUMENT TYPE: FD 3-1/4" Ø BRASS DISK IN MON BOX
ON SURFACE - BELOW:
LEFT - CL PAV'T - RIGHT: 0.50'



MISC. INFORMATION

