

# OTTAWA COUNTY ENGINEERS OFFICE


REFERENCE NO. 9-6-16-H  
SOUTH QUARTER POST SEC. 9  
BAY TWP.  
SHEET 1 OF 1.

ROUTE: C-17 OAK HARBOR SOUTHEAST RD.  
TOWNSHIP: BAY  
SECTION: 9  
T 6 NR 16 E.

PERSONNEL:  
M. WITTMAN, P.S.  
J. ALLEN

NORTHING:  
EASTING:  
DATUM:

DATE / WEATHER / TEMP:  
JUNE 18, 2012  
SUNNY - S  
80° F

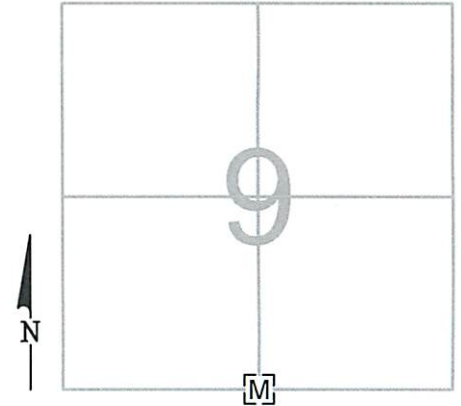

## MONUMENT INFORMATION

MONUMENT TYPE: FD 1" SQ IRON PIN IN MON BOX  
ON SURFACE - BELOW: 0.35'  
LEFT - CL PAV'T - RIGHT:



## MISC. INFORMATION

