

# OTTAWA COUNTY ENGINEERS OFFICE


REFERENCE NO. 9-6-16-1  
SOUTHEAST CORNER SEC. 9  
BAY TWP.  
SHEET 1 OF 1.

ROUTE: C-17 OAK HARBOR SOUTHEAST RD.  
TOWNSHIP: BAY  
SECTION: 9  
T 6 NR 16 E.

PERSONNEL:  
M. WITTMAN, P.S.  
J. ALLEN

NORTHING:  
EASTING:  
DATUM:

DATE / WEATHER / TEMP:  
JUNE 18, 2012  
SUNNY - S  
79° F

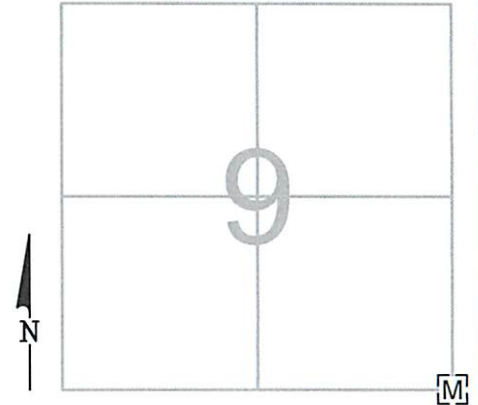

## MONUMENT INFORMATION

MONUMENT TYPE: FD 1" SQ IRON PIN IN MON BOX  
ON SURFACE - BELOW: 0.10'  
LEFT - CL PAV'T - RIGHT:  
DRILL HOLE IN IRON PIN



## MISC. INFORMATION

IRON PIN IS ALMOST AGAINST WEST SIDE OF  
MONUMENT BOX

