


OTTAWA COUNTY BENCHMARK DATA SHEET

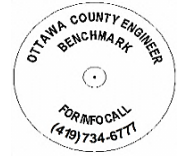

BEN 21-4.0


Township	Section	Town	Range	Type of Monument
Benton	16	T7N	R14E	3 1/4" Domed Bronze Disk in Concrete (OCE Spec. BM-1)
Set By	Shot By	Calculated	Calculated By	Published
OCE / OCHD	J. Allen	March 14, 2012	M. J. Wittman, P.S.	March 16, 2012

Location

Southwest corner of the intersection of Stange Rd., T.R. #21 & Trowbridge Rd., T.R. #67

Vertical Control		
Vertical Datum	Method	Elevation (U.S. Survey Feet)
NAVD 88	GPS	585.43

Horizontal Control			
Horizontal Datum	Zone	Northing	Easting
NAD 83 CORS 96	OHIO NORTH 3401	695,982.260	1,765,642.505
Method	Latitude	Longitude	
GPS / CORPSCON	41° 34' 28.56964" N	83° 14' 29.04929" W	
Geoid	Scale Factor	Convergence	
GEOID 09	0.999978228	- 00° 29' 13.43277"	

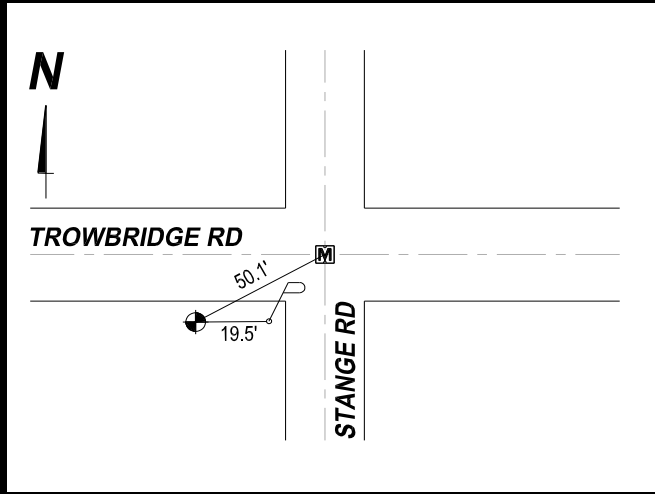

NOTES:

1. Monument set: August 15, 2011
2. Data Collected: 2-2-12, 2-24-12, 3-9-12