

# OTTAWA COUNTY ENGINEERS OFFICE

REFERENCE NO. 1-7-14-D  
WEST QUARTER POST SEC. 1  
BENTON TWP.  
SHEET 1 OF 1.

ROUTE: C-22 LICKERT-HARDER RD.

TOWNSHIP: BENTON

SECTION: 1

T 7 NR 14 E.


PERSONNEL:  
M. WITTMAN, P.S.  
J. ALLEN

NORTHING:

EASTING:

DATE / WEATHER / TEMP:  
JULY 24, 2017  
OVERCAST - N  
68° F

DATUM:

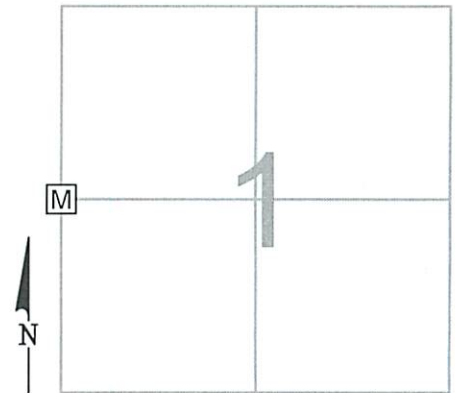

## MONUMENT INFORMATION

MONUMENT TYPE: SET 1" SQ. IRON PIN IN MON BOX  
ON SURFACE - BELOW:  
LEFT - CL PAV'T - RIGHT: 1.40'



## MISC. INFORMATION

DUG FOR IRON PIN OF RECORD. NOTHING FOUND.  
SET IRON PIN IN MONUMENT BOX BASED ON  
EXISTING ROAD PLANS AND SURVEYS AND FIELD  
MEASUREMENTS.

JULY 24, 2017

SET 1" SQUARE IRON PIN  
IN MONUMENT BOX

