

OTTAWA COUNTY ENGINEERS OFFICE

REFERENCE NO. 1-7-14-H
SOUTH QUARTER POST SEC. 1
BENTON TWP.
SHEET 1 OF 1.

ROUTE: C-24 DUFF-WASHA RD.

TOWNSHIP: BENTON

SECTION: 1

T 7 NR 14 E.

PERSONNEL:
M. WITTMAN, P.S.
J. ALLEN


NORTHING:

EASTING:

DATE / WEATHER / TEMP:

MAY 20, 2013
OVERCAST E-NE
80° F

DATUM:

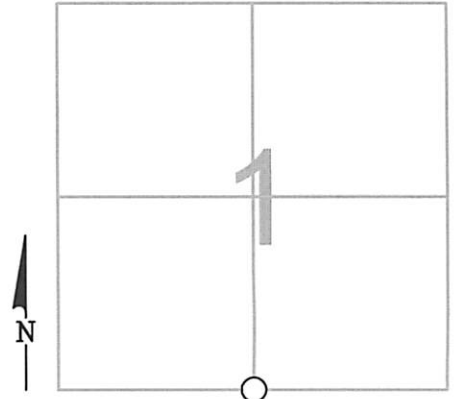

MONUMENT INFORMATION

MONUMENT TYPE: FD 1-1/4" Ø IRON PIN
ON SURFACE - BELOW: 0.23'
LEFT - CL PAV'T - RIGHT: 1.20'

REMOVED BENT PIN SAND RESET 1" SQUARE IRON
PIN IN LOCATION OF STRAIGHT PART OF BENT PIN



MISC. INFORMATION

TOP 5" OF IRON PIN WAS BENT TO THE EAST 0.32'
FROM WHERE IT WENT INTO THE GROUND
STRAIGHT.

MAY 20, 2013

SET 1" SQUARE IRON PIN
IN MONUMENT BOX

