

OTTAWA COUNTY ENGINEERS OFFICE

REFERENCE NO. 1-7-14-I
SE CORNER POST SEC. 1
BENTON TWP.
SHEET 1 OF 1.

PERSONNEL:
M. WITTMAN, P.S.
J. ALLEN

DATE / WEATHER / TEMP:
SEPTEMBER 1, 2009
SUNNY
67° F

ROUTE: C-23 BENTON - CARROLL RD.
@ C-24 DUFF - WASHA RD.

TOWNSHIP: BENTON


SECTION: 1

T 7 NR 14 E.

NORTHING:


EASTING:

DATUM:

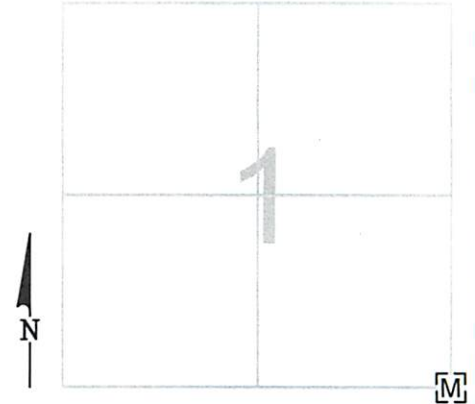

MONUMENT INFORMATION

MONUMENT TYPE: FD. 1-1/4" Ø IRON PIN IN
MONUMENT BOX
ON SURFACE - BELOW:
LEFT - CL PAV'T - RIGHT: 3.50'

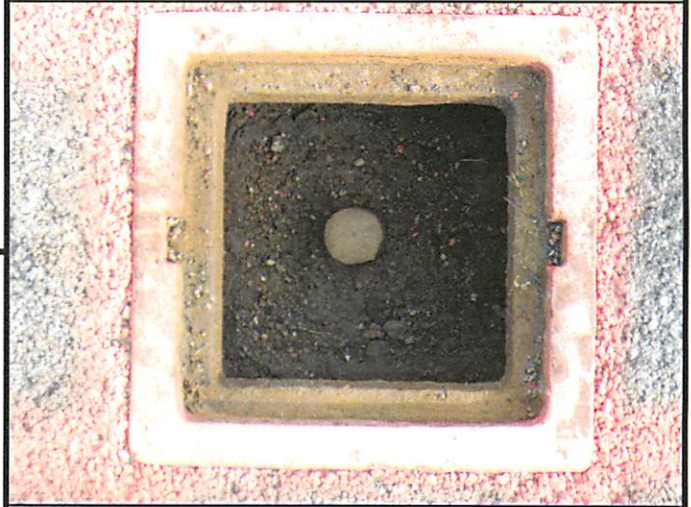

MISC. INFORMATION

