

# OTTAWA COUNTY ENGINEERS OFFICE

REFERENCE NO. 10-7-14-A  
NORTHWEST CORNER SEC. 10  
BENTON TWP.  
SHEET 1 OF 1.

ROUTE: T-21 STANGE RD.  
@ T-68 WALBRIDGE E. RD.

TOWNSHIP: BENTON

SECTION: 10

T 7 NR 14 E.


NORTHING:

EASTING:

DATUM:

PERSONNEL:  
M. WITTMAN, P.S.  
J. ALLEN

DATE / WEATHER / TEMP:  
SEPTEMBER 18, 2008  
SUNNY NE  
70° F

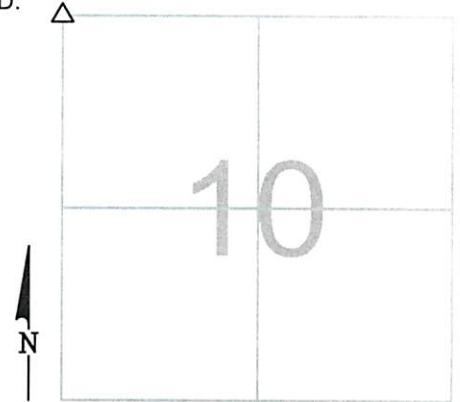

## MONUMENT INFORMATION

MONUMENT TYPE: FD STONE W/ DRILL HOLE  
ON SURFACE - BELOW: 0.85'  
LEFT - CL PAVT - RIGHT:  
RECTANGULAR STONE: 14" x 8" TOP



## MISC. INFORMATION

SEPTEMBER 18, 2008

SET 1" SQUARE IRON PIN  
IN MONUMENT BOX OVER  
STONE

