

OTTAWA COUNTY ENGINEERS OFFICE

REFERENCE NO. 10-7-14-B
NORTH QUARTER POST SEC. 10
BENTON TWP.
SHEET 1 OF 1.

ROUTE: T-68 WALBRIDGE EAST RD.

TOWNSHIP: BENTON

SECTION: 10

T 7 NR 14 E.


PERSONNEL:
M. WITTMAN, P.S.
J. ALLEN

NORTHING:

EASTING:

DATE / WEATHER / TEMP:
AUGUST 31, 2021
OVERCAST - NE
76° F

DATUM:

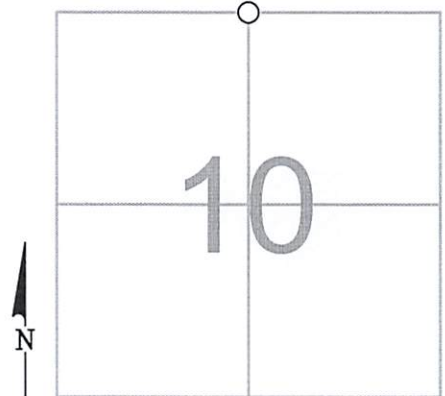

MONUMENT INFORMATION

MONUMENT TYPE: FD. RAILROAD SPIKE
ON SURFACE - BELOW: 0.18'
LEFT - CL PAV'T - RIGHT: 1.20'

REPLACED RAILROAD SPIKE WITH 1" SQ. IRON PIN
IN A MONUMENT BOX



MISC. INFORMATION

NO STONE FOUND. RAILROAD SPIKE WAS SET PER
SURVEY DATED 1973 BY DAVID BRUNKHORST, SIT
AND ROBERT STEINMILLER, RS. SURVEY STATED
RAILROAD SPIKE WAS ESTABLISHED PER
CHARLES DEWITT SURVEY DATED 1898.
ACCEPTED RAILROAD SPIKE.

AUGUST 31, 2021

SET 1" SQUARE IRON PIN
IN MONUMENT BOX

