

OTTAWA COUNTY ENGINEERS OFFICE

REFERENCE NO. 10-7-14-D
WEST QUARTER POST SEC. 10
BENTON TWP.
SHEET 1 OF 1.

PERSONNEL:
M. WITTMAN, P.S.
J. ALLEN

DATE / WEATHER / TEMP:
MAY 3, 2016
SUNNY - N
59° F

ROUTE: T-21 STANGE RD.

TOWNSHIP: BENTON


SECTION: 10

T 7 NR 14 E.

NORTHING:

EASTING:

DATUM:

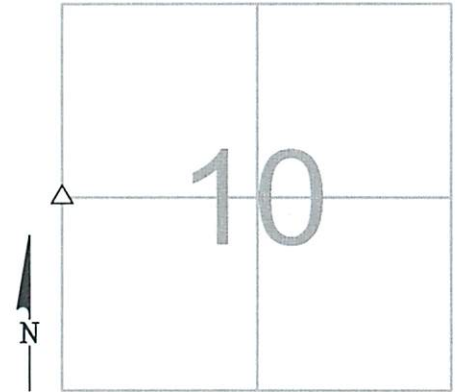

MONUMENT INFORMATION

MONUMENT TYPE: FD. 6"x6" SQ. POINTED LIMESTONE
ON SURFACE - BELOW: 1.73'
LEFT - CL PAV'T - RIGHT: 7.30'

USED HIGH POINT ON THE HIGH RIDGE OF STONE
WHICH IS ON THE EAST THIRD OF THE STONE.



MISC. INFORMATION

FD. MAG SPIKE ON SURFACE WITH 2'-0" TIES
SOUTH AND EAST. TIED WITH X-TIES AND DUG
FOR STONE.

MAG SPIKE WAS 0.02' WEST AND 0.01' SOUTH OF
POINT USED ON STONE.

MAY 3, 2016

SET 1" SQUARE IRON PIN
IN MONUMENT BOX OVER
STONE

