

# OTTAWA COUNTY ENGINEERS OFFICE

REFERENCE NO. 12-7-14-B  
NORTH QUARTER POST SEC. 12  
BENTON TWP.  
SHEET 1 OF 1.

ROUTE: C-24 DUFF-WASHA RD.

TOWNSHIP: BENTON

SECTION: 12

T 7 NR 14 E.

PERSONNEL:  
M. WITTMAN, P.S.  
J. ALLEN


NORTHING:

EASTING:

DATE / WEATHER / TEMP:

MAY 20, 2013  
OVERCAST E-NE  
80° F

DATUM:

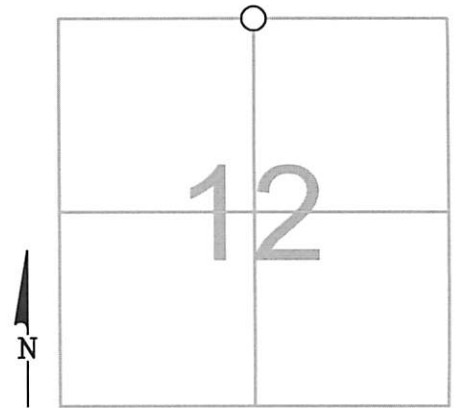

## MONUMENT INFORMATION

MONUMENT TYPE: FD 1-1/4" Ø IRON PIN  
ON SURFACE - BELOW: 0.23'  
LEFT - CL PAV'T - RIGHT: 1.20'

REMOVED BENT PIN SAND RESET 1" SQUARE IRON  
PIN IN LOCATION OF STRAIGHT PART OF BENT PIN



## MISC. INFORMATION

TOP 5" OF IRON PIN WAS BENT TO THE EAST 0.32'  
FROM WHERE IT WENT INTO THE GROUND  
STRAIGHT.

MAY 20, 2013

SET 1" SQUARE IRON PIN  
IN MONUMENT BOX

