

# OTTAWA COUNTY ENGINEERS OFFICE

REFERENCE NO. 12-7-14-C  
NE CORNER POST SEC. 12  
BENTON TWP.  
SHEET 1 OF 1.

PERSONNEL:  
M. WITTMAN, P.S.  
J. ALLEN

DATE / WEATHER / TEMP:  
SEPTEMBER 1, 2009  
SUNNY  
67° F

ROUTE: C-23 BENTON - CARROLL RD.  
@ C-24 DUFF - WASHA RD.

TOWNSHIP: BENTON


SECTION: 12

T 7 N R 14 E.

NORTHING:


EASTING:

DATUM:

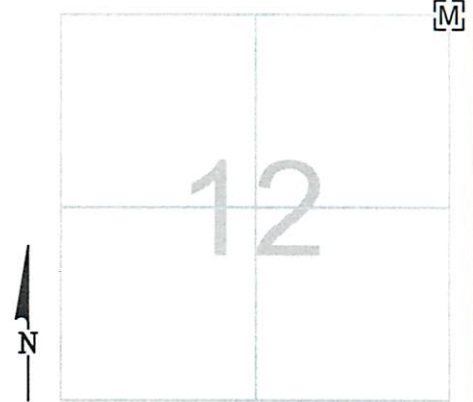

## MONUMENT INFORMATION

MONUMENT TYPE: FD. 1-1/4" Ø IRON PIN IN  
MONUMENT BOX  
ON SURFACE - BELOW:  
LEFT - CL PAV'T - RIGHT: 3.50'

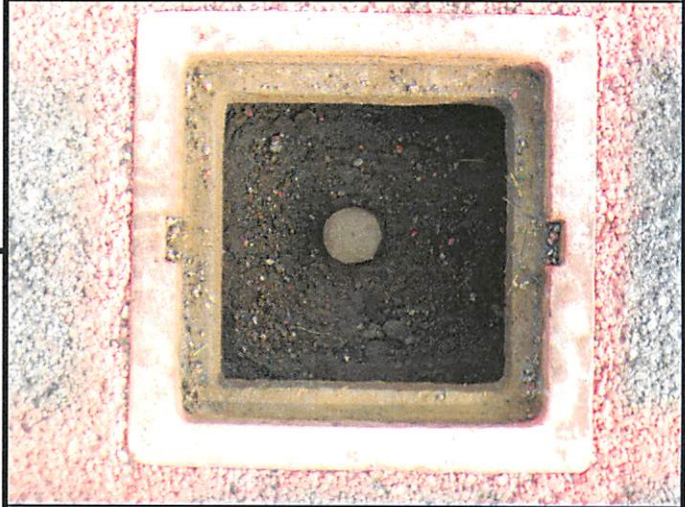

## MISC. INFORMATION

