

# OTTAWA COUNTY ENGINEERS OFFICE

REFERENCE NO. 12-7-14-I  
SOUTHEAST CORNER SEC 12  
BENTON TWP.  
SHEET 1 OF 1.

ROUTE: C-23 BENTON-CARROLL RD.

TOWNSHIP: BENTON

SECTION: 12

T 7 NR 14 E.

**PERSONNEL:**

M. WITTMAN, P.S.  
J. ALLEN  
C. MILLER


NORTHING:

EASTING:

**DATE / WEATHER / TEMP:**

JUNE 5, 2009  
SUNNY N  
70° F

DATUM:

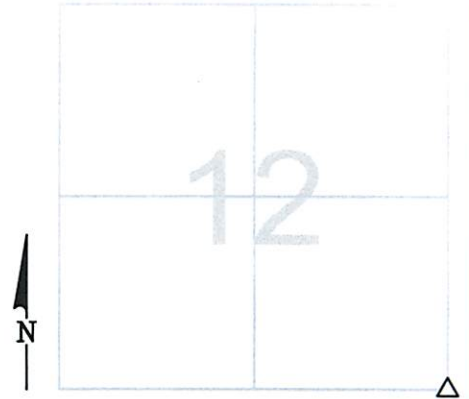

MONUMENT INFORMATION

MONUMENT TYPE: FD HARDHEAD STONE  
ON SURFACE - BELOW: 1.23'  
LEFT - CL PAV'T - RIGHT: 0.60'  
RECTANGULAR STONE: 5" x 7"

USED CENTER OF STONE



MISC. INFORMATION

FD. 1 1/2" Ø IRON PIN 0.25' BELOW SURFACE.  
TIED WITH CROSS TIES AND DUG FOR STONE.  
FD. IRON PIN WAS 10" LONG, 0.13' NORTH AND  
0.02' EAST OF CENTER OF STONE.

JUNE 5, 2009

SET 1" SQUARE IRON PIN  
IN MONUMENT BOX OVER  
STONE

