

OTTAWA COUNTY ENGINEERS OFFICE

REFERENCE NO. 14-7-14-1
 SE CORNER POST SEC. 14
 BENTON TWP.
 SHEET 1 OF 1.

ROUTE: T-22 LICKERT-HARDER RD.

TOWNSHIP: BENTON

SECTION: 14

T 7 NR 14 E.

PERSONNEL:
 M. WITTMAN, P.S.
 J. ALLEN
 J. TIMMONS


NORTHING:

EASTING:

DATE / WEATHER / TEMP:

JULY 26, 2016
 SUNNY - NE
 85° F - HUMID

DATUM:

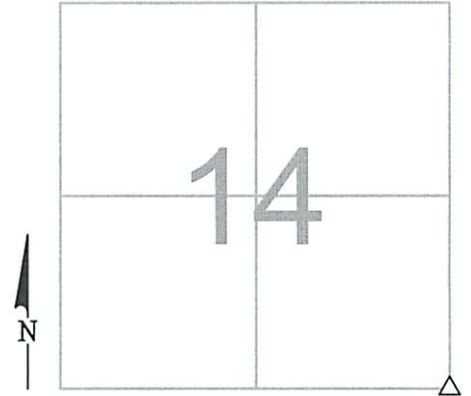

MONUMENT INFORMATION

MONUMENT TYPE: FD. 5"x6" RECTANGULAR STONE
 ON SURFACE - BELOW: 0.99'
LEFT - CL PAV'T - RIGHT: 3.00'

USED CENTER OF STONE



MISC. INFORMATION

FD. MAG SPIKE ON SURFACE TIED WITH X-TIES
 AND DUG FOR STONE.

MAG SPIKE WAS OVER THE POINT USED ON THE
 STONE.

JULY 26, 2016

SET 1" SQUARE IRON PIN
 IN MONUMENT BOX OVER
 STONE

SET 5/8" IRON
 PIN w/ OCE
 CAP FOR
 REF. TIE
 5' W OF EOP

SET 5/8" IRON
 PIN w/ OCE
 CAP FOR
 REF. TIE
 2' E OF EOP

SET 5/8" IRON
 PIN w/ OCE
 CAP FOR
 REF. TIE
 5' W OF EOP

SET 5/8" IRON
 PIN w/ OCE
 CAP FOR
 REF. TIE
 2' E OF EOP

