

# OTTAWA COUNTY ENGINEERS OFFICE

REFERENCE NO. 16-7-14-B  
NORTH QUARTER POST SEC 16  
BENTON TWP.  
SHEET 1 OF 1.

ROUTE: T-67 TROWBRIDGE RD.

TOWNSHIP: BENTON

SECTION: 16

T 7 NR 14 E.

PERSONNEL:  
M. WITTMAN, P.S.  
J. ALLEN


NORTHING:

EASTING:

DATUM:

DATE / WEATHER / TEMP:

JUNE 20, 2011  
OUTCAST HUMID  
70° F

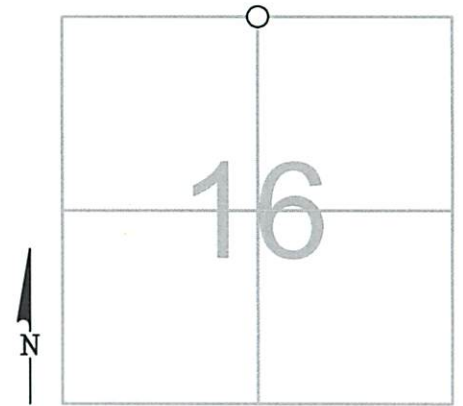

## MONUMENT INFORMATION

MONUMENT TYPE: RAILROAD SPIKE  
ON SURFACE - BELOW: 0.24'  
LEFT - CL PAV'T - RIGHT:



## MISC. INFORMATION

TIED W/ X-TIES & DUG FOR STONE PER DEWITT 1893  
DID NOT FIND STONE  
SHOT FROM X-TIES FROM RR SPK  
TO WEST 2676.99' (2677 R) IP IN MON BOX  
TO EAST 2675.52' (2675.25R) IP IN MON BOX  
INT  $\angle$  179° 51'26" (179°52'R)  
ACCEPTED RAILROAD SPIKE

JUNE 21, 2011

RESET 1" SQUARE IRON PIN  
IN MONUMENT BOX

