

OTTAWA COUNTY ENGINEERS OFFICE

REFERENCE NO. 16-7-14-D
 WEST QUARTER POST SEC. 16
 BENTON TWP.
 SHEET 1 OF 1.

ROUTE: C-19 GRAYTOWN RD.

TOWNSHIP: BENTON

SECTION: 16

T 7 NR 14 E.


PERSONNEL:
 M. WITTMAN, P.S.
 J. ALLEN
 C. MILLER

NORTHING:

EASTING:

DATE / WEATHER / TEMP:
 OCTOBER 28, 2010
 OVERCAST - SW
 49° F

DATUM:

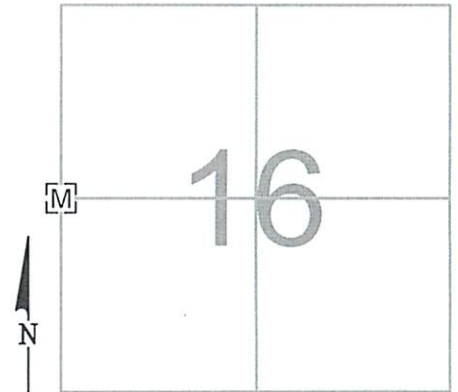

MONUMENT INFORMATION

MONUMENT TYPE: FD. 1-3/4" Ø IRON PIPE IN
 MONUMENT BOX
 ON SURFACE - BELOW: 0.81'
LEFT - CL PAV'T - RIGHT: 2.12'



MISC. INFORMATION

8-17-17 - M. WITTMAN, P.S., J. ALLEN
 SET 5/8" Ø IRON PIN IN CENTER OF 1-3/4" Ø IRON
 PIPE AND RAISED MONUMENT BOX DUE TO ROAD
 PROFILE CHANGE IN CONJUNCTION WITH
 LaCARPE CREEK BRIDGE REPLACEMENT
 PROJECT.

OCTOBER 28, 2010

SET MONUMENT BOX
 OVER EXISTING MONUMENT
 BOX TO BRING TO SURFACE

