

OTTAWA COUNTY ENGINEERS OFFICE

REFERENCE NO. 16-7-14-H
 SOUTH QUARTER POST SEC. 16
 BENTON TWP.
SHEET 1 OF 1.

ROUTE: T-66 MOLINE MARTIN RD. @
 T-20 SUHRBIER RD.

TOWNSHIP: BENTON


SECTION: 16

T 7 **NR** 14 **E.**

NORTHING:

EASTING:

DATUM:

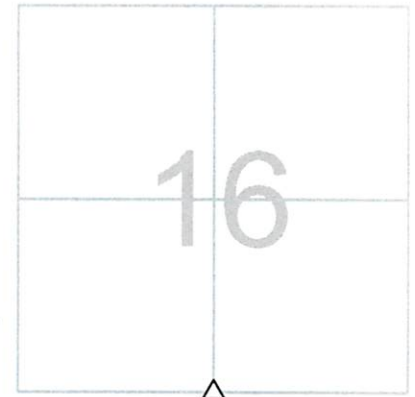

PERSONNEL:
 M. WITTMAN, P.S.
 M. BROUGH
 R. STONER

DATE / WEATHER / TEMP:
 JULY 16, 2003
 SUNNY
 85° F

MONUMENT INFORMATION

MONUMENT TYPE: FD POINTED LIMESTONE
 ON SURFACE - BELOW: 1.45'
 LEFT - CL PAV'T - RIGHT:
 RECTANGULAR STONE: 9" x 9"

 USED FD DRILL HOLE IN STONE.



MISC. INFORMATION

JULY 16, 2003

SET 1" SQUARE IRON PIN
 IN MONUMENT BOX OVER
 STONE

