

OTTAWA COUNTY ENGINEERS OFFICE

REFERENCE NO. 17-7-14-B
NORTH QUARTER POST SEC. 17
BENTON TWP.
SHEET 1 OF 1.

PERSONNEL:
M. WITTMAN, P.S.
J. ALLEN

DATE / WEATHER / TEMP:
JUNE 27, 2013
SUNNY - HUMID
72° F

ROUTE: T-67 TROWBRIDGE RD.

TOWNSHIP: BENTON


SECTION: 17

T 7 NR 14 E.

NORTHING:

EASTING:

DATUM:

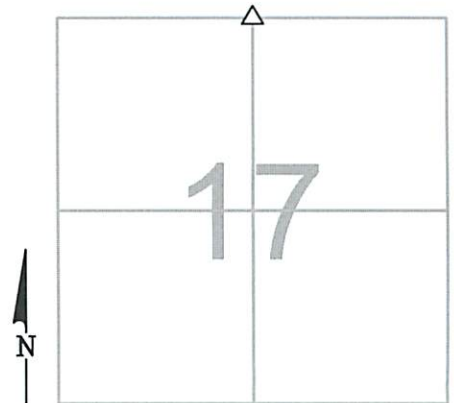

MONUMENT INFORMATION

MONUMENT TYPE: FD 18" x 16" FLAT TOP STONE
ON SURFACE - BELOW: 0.69'
LEFT - CL PAV'T - RIGHT: 2.00'

STONE IS 18" E/W & 16" N/S

SET DRILL HOLE IN STONE



MISC. INFORMATION

APPEARS BY DIMENSIONS OF STONE FOUND AND
STONE RECORD, THAT STONE FOUND IN 1978 WAS
NOT FULLY EXCAVATED. SET A DRILL HOLE IN
STONE WHERE SURFACE PK WAS FOUND AS PK
DID FIT WITH THE CENTER OF THE STONE.

JUNE 27, 2013

SET MONUMENT BOX OVER
STONE

