

# OTTAWA COUNTY ENGINEERS OFFICE

REFERENCE NO. 17-7-14-D  
WEST QUARTER POST SEC 17  
BENTON TWP.  
SHEET 1 OF 1.

ROUTE: C-208 ELLISTON-TROWBRIDGE RD.

TOWNSHIP: BENTON

SECTION: 17

T 7 NR 14 E.

PERSONNEL:  
M. WITTMAN, P.S.  
J. ALLEN


NORTHING:

EASTING:

DATE / WEATHER / TEMP:

MARCH 23, 2012  
SUNNY  
65° F

DATUM:

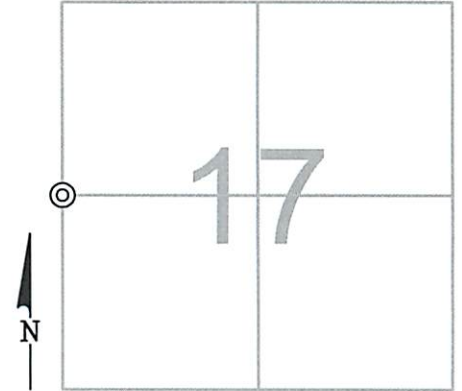

## MONUMENT INFORMATION

MONUMENT TYPE: FD 1" Ø IRON PIPE  
ON SURFACE - BELOW: 0.55'  
LEFT - CL PAV'T - RIGHT: 3.1'



## MISC. INFORMATION

FD. PK ON SURFACE W/ 2'-0" TIES, DUG AND  
FOUND IRON PIPE PER COUNTY RECORDS

MARCH 23, 2012

SET MONUMENT BOX OVER  
1" Ø IRON PIPE

