OTTAWA COUNTY ENGINEERS OFFICE

REFERENCE NO. 17-7-14-F

EAST QUARTER POST SEC. 17

BENTON TWP.

SHEET 1 OF 1.

ROUTE: C-19 GRAYTOWN RD.

TOWNSHIP: BENTON

SECTION: 17

T 7 NR 14 E.

PERSONNEL:

M. WITTMAN, P.S.

J. ALLEN

C. MILLER

NORTHING:

EASTING:


DATE / WEATHER / TEMP:

OCTOBER 28, 2010 OVERCAST - SW

49° F

EACTING.

DATUM:

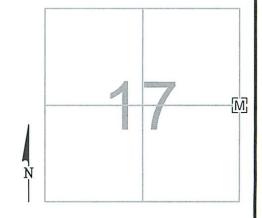

MONUMENT INFORMATION

MONUMENT TYPE: FD. 1-3/4" Ø IRON PIPE IN

MONUMENT BOX

ON SURFACE - <u>BELOW</u>: 0.81' LEFT - CL PAV'T - RIGHT: 2.12'

MISC. INFORMATION

8-17-17 - M. WITTMAN, P.S, J, ALLEN SET 5/8" Ø IRON PIN IN CENTER OF 1-3/4" Ø IRON PIPE AND RAISED MONUMENT BOX DUE TO ROAD PROFILE CHANGE IN CONJUNCTION WITH Lacarpe Creek Bridge Replacement PROJECT.

