

# OTTAWA COUNTY ENGINEERS OFFICE

REFERENCE NO. 17-7-14-H  
SOUTH QUARTER POST SEC. 17  
BENTON TWP.  
SHEET 1 OF 1.

ROUTE: T-66 MOLINE - MARTIN RD.

TOWNSHIP: BENTON

SECTION: 17

T 7 NR 14 E.


**PERSONNEL:**

M. WITTMAN, P.S.  
J. ALLEN  
E. KOCH  
K. BECK

NORTHING:

EASTING:

DATUM:

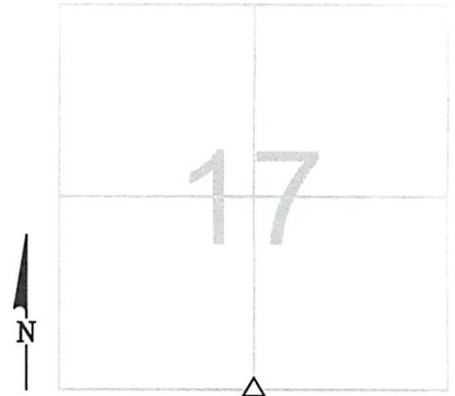

**DATE / WEATHER / TEMP:**

MAY 10, 2010  
SUNNY - E  
54° F

MONUMENT INFORMATION

MONUMENT TYPE: FD. 5"x10" LIMESTONE WITH  
DRILL HOLE  
ON SURFACE - BELOW: 0.85'  
LEFT - CL PAV'T - RIGHT: 0.50'

USED DRILL HOLE



MISC. INFORMATION

MAY 10, 2010

SET 1" SQUARE IRON PIN  
IN MONUMENT BOX OVER  
STONE

