

OTTAWA COUNTY ENGINEERS OFFICE

REFERENCE NO. 18-7-14-D
WEST QUARTER POST SEC. 18
BENTON TWP.
SHEET 1 OF 1.

ROUTE: C-213 NISSEN RD.

TOWNSHIP: BENTON

SECTION: 18

T 7 NR 14 E.


NORTHING:

EASTING:

DATUM:

PERSONNEL:
M. WITTMAN, P.S.
J. ALLEN

DATE / WEATHER / TEMP:
MAY 22, 2012
OVERCAST N-NE
67° F

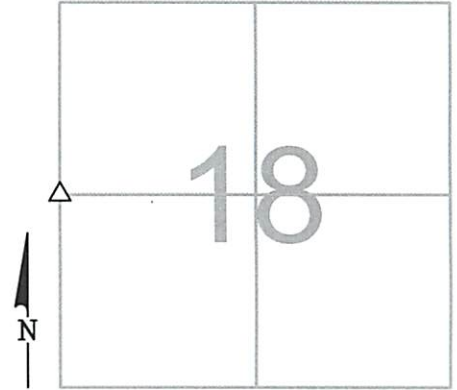

MONUMENT INFORMATION

MONUMENT TYPE: FD. 5" X 7" POINTED STONE
ON SURFACE - BELOW: 1.73'
LEFT - CL PAV'T - RIGHT: 2.0'

TRIANGULAR STONE

USED CENTER OF SMALL PLATEAU ON STONE



MISC. INFORMATION

FD. PK NAIL 0.29' BELOW SURFACE W/ 2'-0" TIES N, S
& W. TIED W/ X-TIES AND DUG FOR STONE. PK
FOUND MATCHED POINT USED ON STONE.

THIS IS A CLOSING CORNER

MAY 22, 2012

SET 1" SQUARE IRON PIN
IN MONUMENT BOX OVER
STONE

