

# OTTAWA COUNTY ENGINEERS OFFICE

**REFERENCE NO.** 18-7-14-F  
EAST QUARTER POST SEC 18  
BENTON TWP.  
**SHEET** 1 OF 1.

**ROUTE:** C-208 ELLISTON-TROWBRIDGE RD.

**TOWNSHIP:** BENTON

**SECTION:** 18


**T** 7 **NR** 14 **E.**

**PERSONNEL:**  
M. WITTMAN, P.S.  
J. ALLEN

**NORTHING:**

**EASTING:**

**DATUM:**

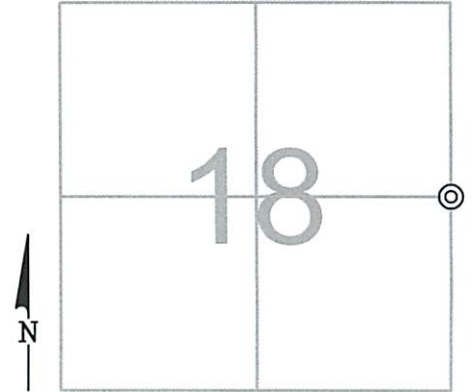

**DATE / WEATHER / TEMP:**

MARCH 23, 2012  
SUNNY  
65° F

## MONUMENT INFORMATION

MONUMENT TYPE: FD 1" Ø IRON PIPE  
ON SURFACE - BELOW: 0.55'  
LEFT - CL PAV'T - RIGHT: 3.1'



## MISC. INFORMATION

FD. PK ON SURFACE W/ 2'-0" TIES, DUG AND  
FOUND IRON PIPE PER COUNTY RECORDS

MARCH 23, 2012

SET MONUMENT BOX OVER  
1" Ø IRON PIPE

