

OTTAWA COUNTY ENGINEERS OFFICE

REFERENCE NO. 18-7-14-G
SOUTHWEST CORNER SEC. 18
BENTON TWP.
SHEET 1 OF 1.

ROUTE: C-213 NISSEN RD.
@ C-66 MOLINE - MARTIN RD.

TOWNSHIP: BENTON

SECTION: 18

T 7 NR 14 E.


NORTHING:

EASTING:

DATUM:

PERSONNEL:
M. WITTMAN, P.S.
J. ALLEN

DATE / WEATHER / TEMP:
JUNE 15, 2012
SUNNY - N
85° F

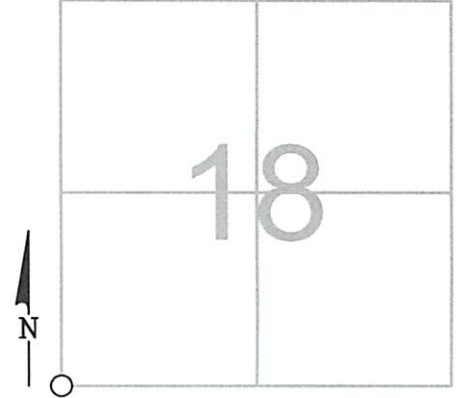

MONUMENT INFORMATION

MONUMENT TYPE: SET 1" SQ IRON PIN IN MON BOX
ON SURFACE - BELOW:
LEFT - CL PAVT - RIGHT:

IRON PIN SET 182.16' NORTH OF SOUTHEAST
CORNER ALLEN SECTION 13 ON EAST LINE OF
SOUTHEAST QUARTER OF ALLEN SECTION 13



MISC. INFORMATION

FD RAILROAD SPIKE AT THIS POINT 0.32' BELOW SURFACE.
TIED WITH X-TIES AND DUG FOR STONE. NO STONE WAS
FOUND. RESET POINT ON EAST LINE OF SOUTHEAST
QUARTER OF ALLEN SECTION 13 PER ORIGINAL
GOVERNMENT SURVEY NOTES. RAILROAD SPIKE WAS
0.17' W AND 0.14' S OF NEW IRON PIN.

THIS IS A CLOSING CORNER

JUNE 15, 2012

SET 1" SQUARE IRON PIN
IN MONUMENT BOX

