

# OTTAWA COUNTY ENGINEERS OFFICE


REFERENCE NO. 18-7-14-H  
SOUTH QUARTER POST SEC. 18  
BENTON TWP.  
SHEET 1 OF 1.

ROUTE: C-66 MOLINE-MARTIN RD.  
TOWNSHIP: BENTON  
SECTION: 18  
T 7 NR 14 E.

PERSONNEL:  
M. WITTMAN, P.S.  
J. ALLEN

NORTHING:  
EASTING:  
DATUM:

DATE / WEATHER / TEMP:  
JULY 24, 2014  
SUNNY, E-NE  
74° F

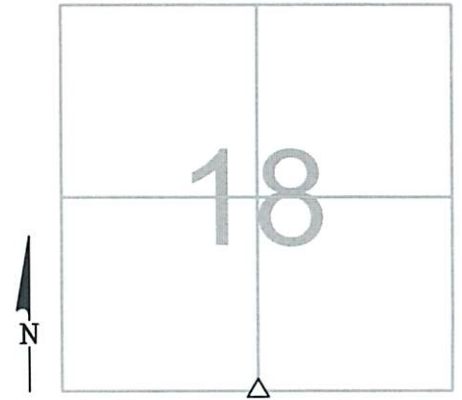

## MONUMENT INFORMATION

MONUMENT TYPE: FD 8"X5" POINTED LIMESTONE  
ON SURFACE - BELOW: 1.27'  
LEFT - CL PAV'T - RIGHT: 4.6'  
USED HIGH POINT ON STONE.



## MISC. INFORMATION

FD. MAG NAIL 0.17' BELOW SURFACE W/ 2' TIES N, E  
& S, TIED X/ X-TIES AND DUG FOR STONE.  
FD MAG NAIL WAS 0.02' E AND 0.09' S OF HIGH  
POINT USED ON STONE.

ARCH 27, 2006

SET 1" SQUARE IRON PIN  
IN MONUMENT BOX OVER  
STONE

