

OTTAWA COUNTY ENGINEERS OFFICE


REFERENCE NO. 19-7-14-B
NORTH QUARTER POST SEC. 19
BENTON TWP.
SHEET 1 OF 1.

ROUTE: C-66 MOLINE-MARTIN RD.
TOWNSHIP: BENTON
SECTION: 19
T 7 NR 14 E.

PERSONNEL:
M. WITTMAN, P.S.
J. ALLEN

NORTHING:
EASTING:
DATUM:

DATE / WEATHER / TEMP:
JULY 24, 2014
SUNNY, E-NE
74° F

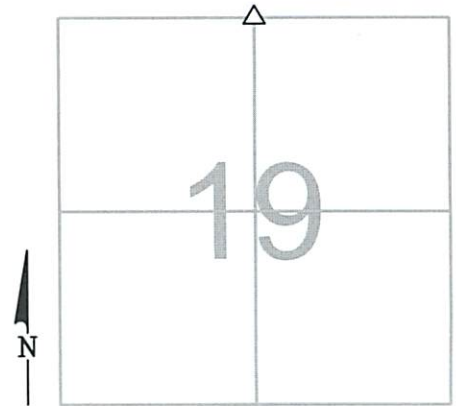

MONUMENT INFORMATION

MONUMENT TYPE: FD 8"X5" POINTED LIMESTONE
ON SURFACE - BELOW: 1.27'
LEFT - CL PAV'T - RIGHT: 4.6'

USED HIGH POINT ON STONE.



MISC. INFORMATION

FD. MAG NAIL 0.17' BELOW SURFACE W/ 2' TIES N, E
& S, TIED X/ X-TIES AND DUG FOR STONE.

FD MAG NAIL WAS 0.02' E AND 0.09' S OF HIGH
POINT USED ON STONE.

ARCH 27, 2006

SET 1" SQUARE IRON PIN
IN MONUMENT BOX OVER
STONE

