


# OTTAWA COUNTY ENGINEERS OFFICE

REFERENCE NO. 19-7-14-D  
 WEST QUARTER POST SEC. 19  
 BENTON TWP.  
 SHEET 1 OF 1.

ROUTE: C-213 NISSEN RD.  
 TOWNSHIP: BENTON  
 SECTION: 19  
 T 7 NR 14 E.

PERSONNEL:  
 M. WITTMAN, P.S.  
 J. ALLEN  
 E. KOCH  
 C. MILLER

NORTHING:  
 EASTING:  
 DATUM:

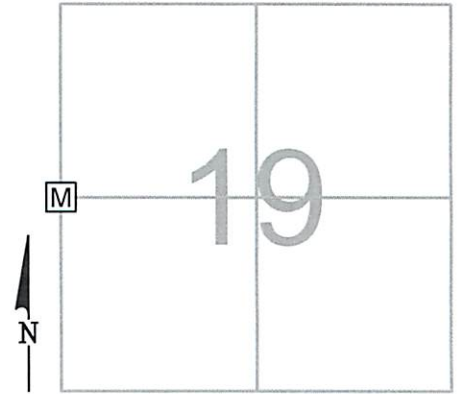

DATE / WEATHER / TEMP:  
 MARCH 29, 2010  
 PTLY SUNNY - N  
 42° F

### MONUMENT INFORMATION

MONUMENT TYPE: SET 1" SQ. IRON PIN IN  
 MONUMENT BOX  
ON SURFACE - BELOW:  
 LEFT - CL PAV'T - RIGHT:



### MISC. INFORMATION

BEC ASSOCIATES DUG FOR STONE PER 1893  
 DeWITT SURVEY IN MARCH 2010 AND DID NOT FIND  
 STONE. THIS OFFICE EXPANDED DIG AND DID NOT  
 FIND STONE. A 1" SQ. IRON PIN WAS SET ON  
 3-29-2010 ON THE EAST LINE OF CLAY TOWNSHIP  
 USING SINGLE PROPORTIONATE MEASUREMENT  
 FROM SW COR. SEC 19 TO NW COR. SEC. 19.  
**THIS IS A CLOSING CORNER**

MARCH 29, 2010

SET 1" SQUARE IRON PIN  
 IN MONUMENT BOX

