


# OTTAWA COUNTY ENGINEERS OFFICE

**REFERENCE NO.** 19-7-14-F  
 E QUARTER POST SECTION 19  
 BENTON TWP.  
**SHEET** 1 OF 1.

**ROUTE:** C-208 ELLISTON TROWBRIDGE RD.  
**TOWNSHIP:** BENTON  
**SECTION:** 19  
**T** 7 **NR** 14 **E.**

**PERSONNEL:**  
 R. NUHFER, P.S.  
 M. WITTMAN, P.S.

**NORTHING:**  
**EASTING:**  
**DATUM:**

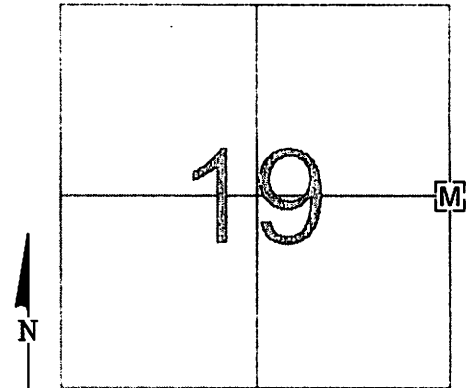

**DATE / WEATHER / TEMP:**  
 JULY 21, 2002  
 SUNNY  
 82° F

MONUMENT INFORMATION

MONUMENT TYPE: FD 1" SQ. IRON PIN IN MON BOX  
 ON SURFACE - BELOW: 0.17'  
 LEFT - CL PAVT - RIGHT:

MISC. INFORMATION

STONE SEARCHED FOR ON 8-21-75 BY  
 R. STEINMILLER, P.S., D. BRUNKHORST, R.S.,  
 A. WEIRICH AND J. YOUNG - STONE NOT FOUND.  
 IRON PIN IN MOUNMENT BOX SET 3-14-83 BY  
 R. STEINMILLER, P.S., P. BELL, P.S., J. UNDERWOOD  
 AND G. FARROW

PHOTO OF STONE NOT AVAILABLE

