

OTTAWA COUNTY ENGINEERS OFFICE

REFERENCE NO. 20-7-14-B
NORTH QUARTER POST SEC. 20
BENTON TWP.
SHEET 1 OF 1.

ROUTE: T-66 MOLINE - MARTIN RD.

TOWNSHIP: BENTON

SECTION: 20

T 7 NR 14 E.


PERSONNEL:

M. WITTMAN, P.S.
J. ALLEN
E. KOCH
K. BECK

NORTHING:

EASTING:

DATUM:

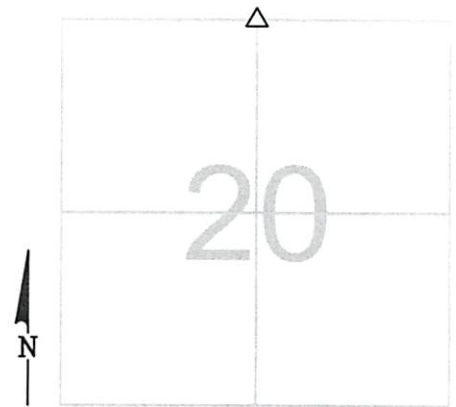

DATE / WEATHER / TEMP:

MAY 10, 2010
SUNNY - E
54° F

MONUMENT INFORMATION

MONUMENT TYPE: FD. 5"x10" LIMESTONE WITH
DRILL HOLE
ON SURFACE - BELOW: 0.85'
LEFT - CL PAV'T - RIGHT: 0.50'

USED DRILL HOLE



MISC. INFORMATION

MAY 10, 2010

SET 1" SQUARE IRON PIN
IN MONUMENT BOX OVER
STONE

