

OTTAWA COUNTY ENGINEERS OFFICE

REFERENCE NO. 20-7-14-D
W QUARTER POST SECTION 20
BENTON TWP.
SHEET 1 OF 1.

ROUTE: C-208 ELLISTON TROWBRIDGE RD.

TOWNSHIP: BENTON

SECTION: 20

T 7 NR 14 E.

PERSONNEL:
R. NUHFER, P.S.
M. WITTMAN, P.S.


NORTHING:

EASTING:

DATUM:

DATE / WEATHER / TEMP:

JULY 21, 2002
SUNNY
82° F

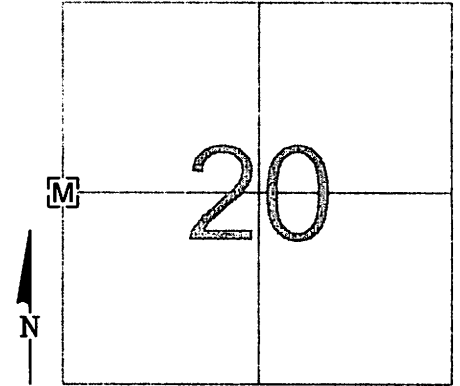

MONUMENT INFORMATION

MONUMENT TYPE: FD 1" SQ. IRON PIN IN MON BOX
ON SURFACE - BELOW: 0.17'
LEFT - CL PAVT - RIGHT:

MISC. INFORMATION

STONE SEARCHED FOR ON 8-21-75 BY
R. STEINMILLER, P.S., D. BRUNKHORST, R.S.,
A. WEIRICH AND J. YOUNG - STONE NOT FOUND.
IRON PIN IN MOUNMENT BOX SET 3-14-83 BY
R. STEINMILLER, P.S., P. BELL, P.S., J. UNDERWOOD
AND G. FARROW

PHOTO OF STONE NOT AVAILABLE

