

OTTAWA COUNTY ENGINEERS OFFICE

REFERENCE NO. 23-7-14-E
 CENTER POST SECTION 23
 BENTON TWP.
 SHEET 1 OF 1.

ROUTE: C-62 TOUSSINT NORTH RD.
 @ C-75 ROCKY RIDGE RD.

TOWNSHIP: BENTON

SECTION: 23

T 7 NR 14 E.


NORTHING:

EASTING:

DATUM:

PERSONNEL:
 M. WITTMAN, P.S.
 J. ALLEN

DATE / WEATHER / TEMP:
 JULY 14, 2014
 PTLY CLOUDY
 73° F

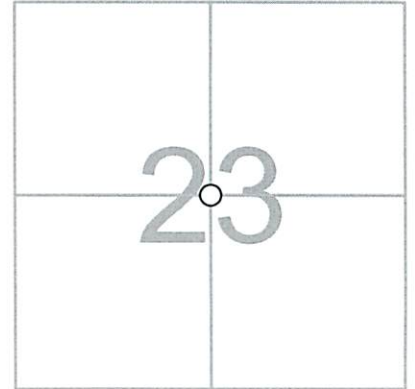

MONUMENT INFORMATION

MONUMENT TYPE: FD RAILROAD SPIKE
 ON SURFACE - BELOW: 0.05'
 LEFT - CL PAV'T - RIGHT: 1.00'



MISC. INFORMATION

RR SPK SET BY R.C. STEINMILLER PER SURVEY
 DATED SEPTEMBER 1977.

JULY 14, 2014

SET 1" SQUARE IRON PIN
 IN MONUMENT BOX IN PLACE
 OF RAILROAD SPIKE

