

OTTAWA COUNTY ENGINEERS OFFICE

REFERENCE NO. 23-7-14-F
 EAST QUARTER POST SEC. 23
 BENTON TWP.
SHEET 1 OF 1.

ROUTE: T-22 LICKERT-HARDER RD.

TOWNSHIP: BENTON

SECTION: 23

T 7 **NR** 14 **E.**

PERSONNEL:
 M. WITTMAN, P.S.
 J. ALLEN
 J. TIMMONS


NORTHING:

EASTING:

DATE / WEATHER / TEMP:

JULY 26, 2016
 SUNNY
 81° F - HUMID

DATUM:

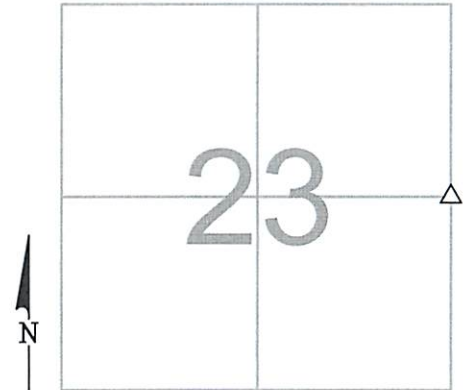

MONUMENT INFORMATION

MONUMENT TYPE: FD. 5"x7" POINTED STONE
 ON SURFACE - BELOW: 1.15'
LEFT - CL PAV'T - RIGHT: 4.00'
 BROKEN CLAY TILE OVER AND AROUND STONE.
 USED CENTER OF STONE PER STEINMILLER NOTES
 FROM 1976.



MISC. INFORMATION

FD. PK NAIL ON SURFACE WITH 6' TIE SE AND 4'
 TIES NE AND NW PER RECORD. TIED WITH
 X-TIES AND DUG FOR STONE.
 PK NAIL WAS OVER THE POINT USED ON THE
 STONE.

JULY 26, 2016

SET 1" SQUARE IRON PIN
 IN MONUMENT BOX OVER
 STONE

SET 5/8" IRON
 PIN w/ OCE
 CAP FOR
 REF. TIE
 2' W OF EOP

SET 5/8" IRON
 PIN w/ OCE
 CAP FOR
 REF. TIE
 2' E OF EOP

USING EXISTING PK'S
 PK SE - 6.05'
 PK NE - 4.02'
 PK NW - 4.02'

SET 5/8" IRON
 PIN w/ OCE
 CAP FOR
 REF. TIE
 2' W OF EOP

