

# OTTAWA COUNTY ENGINEERS OFFICE

REFERENCE NO. 23-7-14-1  
SOUTHEAST CORNER SEC. 23  
BENTON TWP.  
SHEET 1 OF 1.

ROUTE: T-22 LICKERT-HARDER RD.

TOWNSHIP: BENTON

SECTION: 23

T 7 NR 14 E.

**PERSONNEL:**

M. WITTMAN, P.S.  
J. ALLEN  
E. KOCH  
C. MILLER


NORTHING:

EASTING:

DATUM:

**DATE / WEATHER / TEMP:**

JULY 10, 2009  
SUNNY SW  
80° F

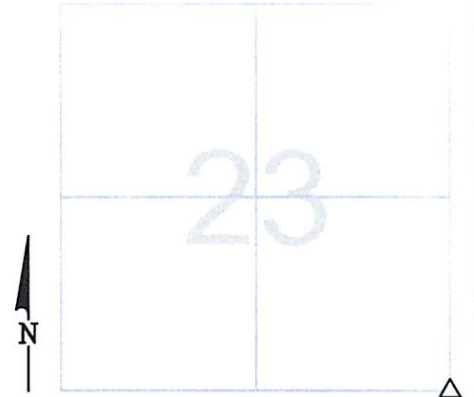

MONUMENT INFORMATION

MONUMENT TYPE: FD HARDHEAD STONE  
ON SURFACE - BELOW: 1.72'  
LEFT - CL PAV'T - RIGHT: 5.00'  
FLAT TRIANGULAR STONE: 12" x 9"

USED CENTER OF STONE.



MISC. INFORMATION

FD. PK NAIL ON SURFACE WHICH MATCHED ONLY TIE FROM 1972 NOTES. TIED W/ CROSS TIES AND DUG FOR STONE. FD PK NAIL WAS 0.08' WEST AND 0.05' NORTH OF CENTER OF STONE.

JULY 10, 2009

SET 1" SQUARE IRON PIN  
IN MONUMENT BOX OVER  
STONE

