

# OTTAWA COUNTY ENGINEERS OFFICE

REFERENCE NO. 24-7-14-D  
 WEST QUARTER POST SEC. 24  
 BENTON TWP.  
 SHEET 1 OF 1.

ROUTE: T-22 LICKERT-HARDER RD.

TOWNSHIP: BENTON

SECTION: 24

T 7 NR 14 E.


PERSONNEL:  
 M. WITTMAN, P.S.  
 J. ALLEN  
 J. TIMMONS

NORTHING:

EASTING:

DATE / WEATHER / TEMP:  
 JULY 26, 2016  
 SUNNY  
 81° F - HUMID

DATUM:

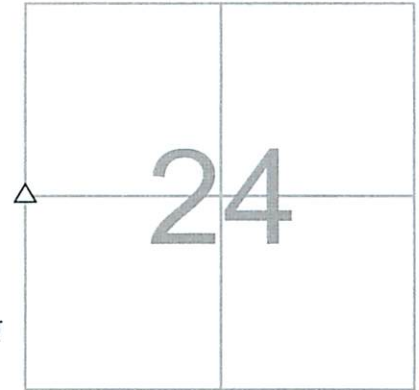

### MONUMENT INFORMATION

MONUMENT TYPE: FD. 5"x7" POINTED STONE  
 ON SURFACE - BELOW: 1.15'  
LEFT - CL PAV'T - RIGHT: 4.00'  
 BROKEN CLAY TILE OVER AND AROUND STONE.  
 USED CENTER OF STONE PER STEINMILLER NOTES  
 FROM 1976.



### MISC. INFORMATION

FD. PK NAIL ON SURFACE WITH 6' TIE SE AND 4'  
 TIES NE AND NW PER RECORD. TIED WITH  
 X-TIES AND DUG FOR STONE.  
 PK NAIL WAS OVER THE POINT USED ON THE  
 STONE.

JULY 26, 2016

SET 1" SQUARE IRON PIN  
 IN MONUMENT BOX OVER  
 STONE

SET 5/8" IRON  
 PIN w/ OCE  
 CAP FOR  
 REF. TIE  
 2' W OF EOP

SET 5/8" IRON  
 PIN w/ OCE  
 CAP FOR  
 REF. TIE  
 2' E OF EOP

USING EXISTING PK'S  
 PK SE - 6.05'  
 PK NE - 4.02'  
 PK NW - 4.02'

SET 5/8" IRON  
 PIN w/ OCE  
 CAP FOR  
 REF. TIE  
 2' W OF EOP

