OTTAWA COUNTY ENGINEERS OFFICE

REFERENCE NO. 24-7-14-F

EAST QUARTER POST SEC 24

BENTON TWP.

SHEET 1 OF 1.

ROUTE: C-23 BENTON-CARROLL RD.

TOWNSHIP: BENTON

SECTION: 24

T 7 NR 14 E.

PERSONNEL:

M. WITTMAN, P.S.

J. ALLEN

C. MILLER

E. KOCH

NORTHING:

EASTING:

DATE / WEATHER / TEMP:

MAY 22, 2009 **OVERCAST NE**

70° F

DATUM:




MONUMENT INFORMATION

MONUMENT TYPE: FD STONE ON SURFACE - BELOW: 1.28' LEFT - CL PAV'T - RIGHT: 8.40' RECTANGULAR STONE: 4 1/2" x 5"

USED CENTER OF STONE

MISC. INFORMATION

FD RAILROAD SPIKE 0.17' BELOW SURFACE. TIED SPIKE AND CONTINUED TO DIG. FOUND ANOTHER RAILROAD SPIKE 0.45' BELOW SURFACE - 0.18' N AND 0.02' OF FIRST SPIKE. FOUND STONE - FIRST RAILROAD SPIKE WAS 0.10' N AND 0.11' W OF STONE.

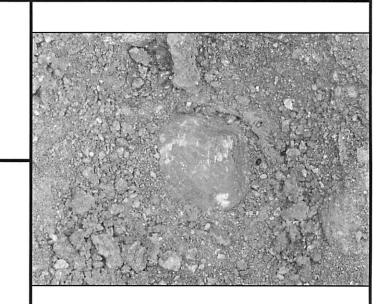

MAY 22, 2009

SET 1" SQUARE IRON PIN IN MONUMENT BOX OVER STONE

