

OTTAWA COUNTY ENGINEERS OFFICE


REFERENCE NO. 26-7-14-B
NORTH QUARTER POST SEC. 26
BENTON TWP.
SHEET 1 OF 1.

ROUTE: C-75 ROCKY RIDGE RD.
TOWNSHIP: BENTON
SECTION: 26
T 7 NR 14 E.

PERSONNEL:
M. WITTMAN, P.S.
J. ALLEN

NORTHING:
EASTING:
DATUM:

DATE / WEATHER / TEMP:
AUGUST 1, 2014
SUNNY, W-NW
85° F

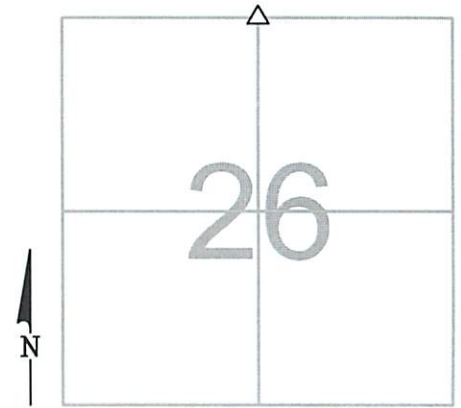

MONUMENT INFORMATION

MONUMENT TYPE: FD. TRIANGULAR POINTED LIMESTONE
ON SURFACE - BELOW: 1.27'
LEFT - CL PAV'T - RIGHT: 1.2'
3-1/2" X 5" TRIANGULAR POINTED STONE.
USED POINT ON STONE.



MISC. INFORMATION

FD PK NAIL ON SURFACE WITH 2' TIES N,S,E & W.
TIED PK W/ GPS AND DUG FOR STONE.
PK NAIL WAS 0.07' EAST AND 0.13' SOUTH OF POINT
ON STONE.

AUGUST 1, 2014

SET 1" SQUARE IRON PIN
IN MONUMENT BOX OVER
STONE

