

OTTAWA COUNTY ENGINEERS OFFICE

REFERENCE NO. 26-7-14-E
CENTER POST SECTION 26
BENTON TWP.
SHEET 1 OF 1.

ROUTE: C-75 ROCKY RIDGE RD.
@ T-77 TRUE RD.

TOWNSHIP: BENTON

SECTION: 26

T 7 NR 14 E.


NORTHING:

EASTING:

DATUM:

PERSONNEL:
M. WITTMAN, P.S.
J. ALLEN

DATE / WEATHER / TEMP:
JULY 31, 2014
SUNNY
80° F

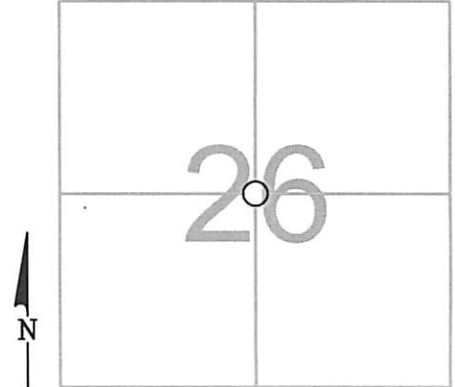

MONUMENT INFORMATION

MONUMENT TYPE: FD 5/8" Ø IRON PIN
ON SURFACE - BELOW: 0.45'
LEFT - CL PAV'T - RIGHT: 0.90'

SET DH IN CENTER OF PIN.



MISC. INFORMATION

IRON PIN SET BY C.A. STEVENSON IN AUGUST 1956
PER SURVEY DATED AUGUST 1956.

JULY 31, 2014

SET MONUMENT BOX OVER PIN

