

OTTAWA COUNTY ENGINEERS OFFICE

REFERENCE NO. 26-7-14-H
SOUTH QUARTER POST SEC. 26
BENTON TWP.
SHEET 1 OF 1.

ROUTE: MAIN ST. @ THIRD ST.
(VILLAGE OF ROCKY RIDGE)

TOWNSHIP: BENTON

SECTION: 26

T 7 NR 14 E.

NORTHING:


EASTING:

DATUM:

PERSONNEL:
M. WITTMAN, P.S.
J. ALLEN

DATE / WEATHER / TEMP:

JULY 31, 2014
SUNNY, N-NW
77° F

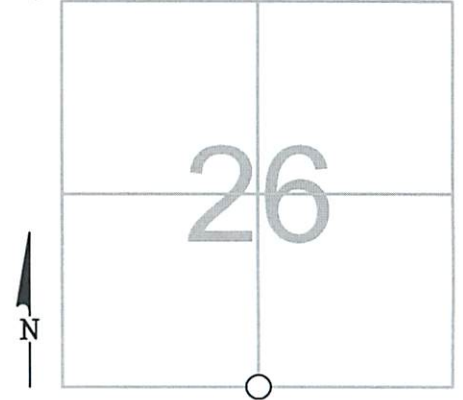

MONUMENT INFORMATION

MONUMENT TYPE: FD 3/4" Ø IRON PIN
ON SURFACE - BELOW: 0.45'
LEFT - CL PAV'T - RIGHT:

SET DH IN CENTER OF PIN.



MISC. INFORMATION

IRON PIN SET BY C.A. STEVENSON IN AUGUST 1956
PER SURVEY DATED AUGUST 1956.

JULY 31, 2014

SET MONUMENT BOX OVER PIN

