

OTTAWA COUNTY ENGINEERS OFFICE

REFERENCE NO. 27-7-14-E
INTERIOR CORNER POST SEC. 27
BENTON TWP.
SHEET 1 OF 1.

ROUTE: T-77 TRUE RD.

TOWNSHIP: BENTON

SECTION: 27

T 7 NR 14 E.

PERSONNEL:
M. WITTMAN, P.S.
J. ALLEN
C. MILLER


NORTHING:

EASTING:

DATE / WEATHER / TEMP:


OCTOBER 28, 2010
OVERCAST - SW
52° F

DATUM:

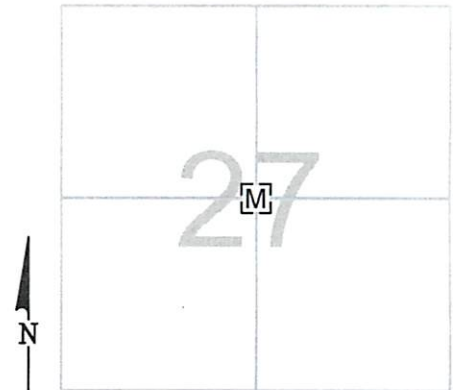

MONUMENT INFORMATION

MONUMENT TYPE: FD. 1" SQ. IRON PIN IN MON. BOX
ON SURFACE - BELOW: 0.31'
LEFT - CL PAV'T - RIGHT: 3.50'

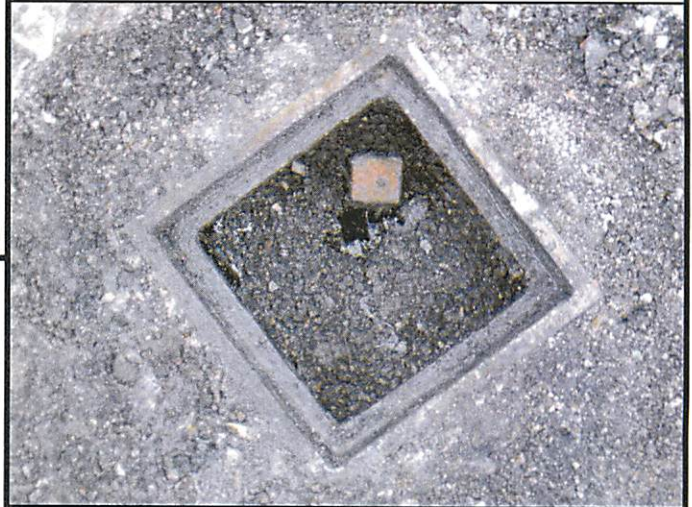

MISC. INFORMATION

