

OTTAWA COUNTY ENGINEERS OFFICE

REFERENCE NO. 28-7-14-D
WEST QUARTER POST SEC 28
BENTON TWP.
SHEET 1 OF 1.

ROUTE: C-19 GRAYTOWN RD.
@ T-77 TRUE RD.

TOWNSHIP: BENTON

SECTION: 28

T 7 N R 14 E.


NORTHING:

EASTING:

DATUM:

PERSONNEL:
M. WITTMAN, P.S.
J. ALLEN

DATE / WEATHER / TEMP:
MARCH 23, 2012
OVERCAST
74° F

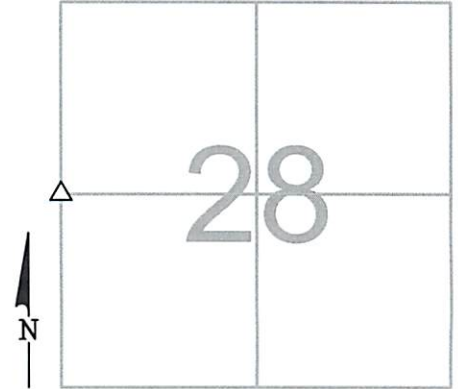

MONUMENT INFORMATION

MONUMENT TYPE: FD LIMESTONE
ON SURFACE - BELOW: 2.28'
LEFT - CL PAV'T - RIGHT: 2.4'
RECTANGULAR STONE: 5" x 3" x 5" W/ FAINT "X"
IN CENTER
USED FAINT "X"



MISC. INFORMATION

MARCH 23, 2012

SET 1" SQUARE IRON PIN
IN MONUMENT BOX OVER
STONE

