

OTTAWA COUNTY ENGINEERS OFFICE


REFERENCE NO. 28-7-14-E
 CENTER POST SECTION 28
 BENTON TWP.
 SHEET 1 OF 1.

ROUTE: T-77 TRUE RD.
 TOWNSHIP: BENTON
 SECTION: 28
 T 7 NR 14 E.

PERSONNEL:
 M. WITTMAN, P.S.
 J. ALLEN

NORTHING:
 EASTING:
 DATUM:

DATE / WEATHER / TEMP:
 AUGUST 5, 2013
 PARTLY SUNNY - S
 67° F

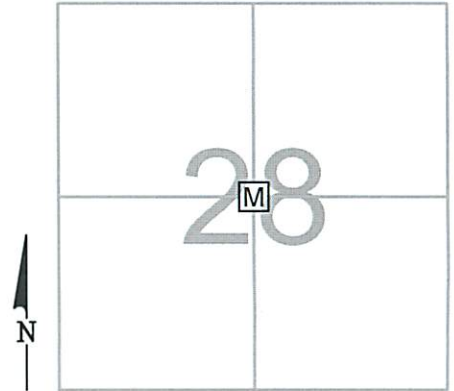

MONUMENT INFORMATION

MONUMENT TYPE: SET 1" SQ. IRON PIN IN MON. BOX
ON SURFACE - BELOW:
 LEFT - CL PAV'T - RIGHT: 8.50'



MISC. INFORMATION

FD RR SPK ON SURFACE 0.91' W AND 10.71' NORTH
 OF LOCATION. NO KNOW ORIGIN FOR RR SPK.
 USED STRAIGHT LINE FROM WEST 1/4 POST TO
 EAST 1/4 POST AND HELD DISTANCE (2648) FROM
 1901 STINEBAUGH SURVEY. OTHER RECORD
 SURVEYS ALSO USED STRAIGHT LINE. NO STONE
 FOUND IN LOCATION.

AUGUST 5, 2013

SET 1" SQUARE IRON PIN
 IN MONUMENT BOX

