

# OTTAWA COUNTY ENGINEERS OFFICE

REFERENCE NO. 28-7-14-G  
SW CORNER POST SEC. 28  
BENTON TWP.  
SHEET 1 OF 1.

ROUTE: C-19 GRAYTOWN RD.  
@ T-78 SONDERGELD RD.

TOWNSHIP: BENTON

SECTION: 28

T 7 NR 14 E.


NORTHING:

EASTING:

DATUM:

PERSONNEL:  
M. WITTMAN, P.S.  
J. ALLEN

DATE / WEATHER / TEMP:  
MARCH 26, 2012  
SUNNY - NE  
38° F

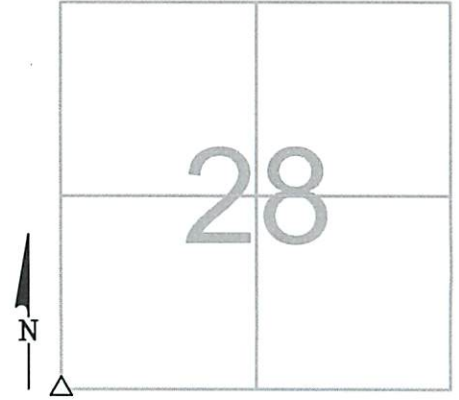

## MONUMENT INFORMATION

MONUMENT TYPE: FD. 9"X13-1/2" HARDHEAD STONE  
ON SURFACE - BELOW: 0.93'  
LEFT - CL PAV'T - RIGHT: 2.40'

9-1/2" HARROWTOOTH SLANTED OVER STONE

SET DRILL HOLE IN CENTER OF STONE



## MISC. INFORMATION

FD. MAG SPIKE ON SURFACE W/ 2' TIES N, S, E & W  
DUG FOR IRON PIN PER RECORDS

HARROWTOOTH FD SLANTED OVER NE COR OF STONE  
NO VISIBLE MARKINGS ON STONE

CENTER OF HARROWTOOTH WHICH WAS UNDER MAG  
SPIKE WAS 0.20' N AND 0.25' E OF CENTER OF STONE

MARCH 26, 2012

SET MONUMENT BOX  
OVER STONE

