

OTTAWA COUNTY ENGINEERS OFFICE

REFERENCE NO. 29-7-14-G
SW CORNER POST SEC. 29
BENTON TWP.
SHEET 1 OF 1.

ROUTE: C-208 ELLISTON-TROWBRIDGE RD.
@ T-55 SOUTH TOUSSAINT RD.

TOWNSHIP: BENTON

SECTION: 29

T 7 NR 14 E.

PERSONNEL:
M. WITTMAN, P.S.
J. ALLEN


NORTHING:

EASTING:

DATUM:

DATE / WEATHER / TEMP:

MARCH 22, 2012
SUNNY
68° F

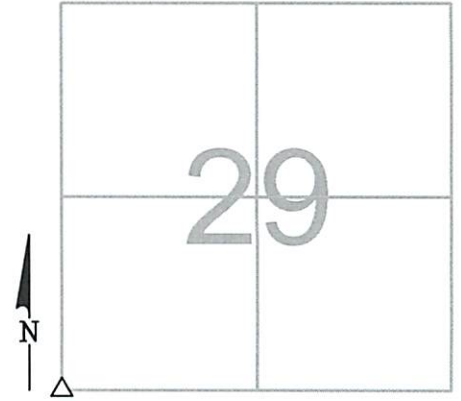

MONUMENT INFORMATION

MONUMENT TYPE: 9" X 9" GRANITE STONE
ON SURFACE - BELOW: 1.57'
LEFT - CL PAV'T - RIGHT: 5.30'
STONE IS ROUND AND FLAT

USED CENTER OF STONE



MISC. INFORMATION

MARCH 22, 2012

SET 1" SQUARE IRON PIN
IN MONUMENT BOX OVER
STONE

