

# OTTAWA COUNTY ENGINEERS OFFICE

**REFERENCE NO.** 29-7-14-I  
 SE CORNER POST SEC. 29  
 BENTON TWP.  
**SHEET** 1 OF 1.

**ROUTE:** C-19 GRAYTOWN RD.  
 @ T-78 SONDERGELD RD.

**TOWNSHIP:** BENTON

**SECTION:** 29

T 7 NR 14 E.


**NORTHING:**

**EASTING:**

**DATUM:**

**PERSONNEL:**  
 M. WITTMAN, P.S.  
 J. ALLEN

**DATE / WEATHER / TEMP:**  
 MARCH 26, 2012  
 SUNNY - NE  
 38° F

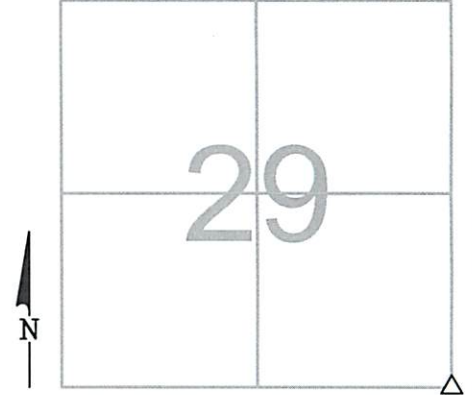

### MONUMENT INFORMATION

MONUMENT TYPE: FD. 9"X13-1/2" HARDHEAD STONE  
 ON SURFACE - BELOW: 0.93'  
LEFT - CL PAV'T - RIGHT: 2.40'

9-1/2" HARROWTOOTH SLANTED OVER STONE

SET DRILL HOLE IN CENTER OF STONE



### MISC. INFORMATION

FD. MAG SPIKE ON SURFACE W/ 2' TIES N, S, E & W  
 DUG FOR IRON PIN PER RECORDS  
 HARROWTOOTH FD SLANTED OVER NE COR OF STONE  
 NO VISIBLE MARKINGS ON STONE  
 CENTER OF HARROWTOOTH WHICH WAS UNDER MAG  
 SPIKE WAS 0.20' N AND 0.25' E OF CENTER OF STONE

MARCH 26, 2012

SET MONUMENT BOX  
 OVER STONE

