

OTTAWA COUNTY ENGINEERS OFFICE

REFERENCE NO. 3-7-14-I
SE CORNER POST SEC. 3
BENTON TWP.
SHEET 1 OF 1.

PERSONNEL:
M. WITTMAN, P.S.
J. ALLEN

DATE / WEATHER / TEMP:
SEPTEMBER 1, 2009
SUNNY
67° F

ROUTE: STATE ROUTE #590

TOWNSHIP: BENTON


SECTION: 3

T 7 NR 14 E.

NORTHING: 701,292.960

EASTING: 1,771,025.845

DATUM: ODOT VRS

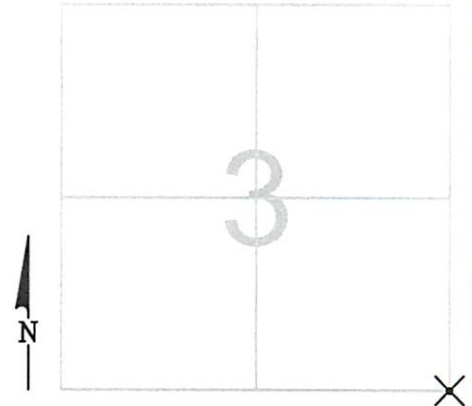

MONUMENT INFORMATION

MONUMENT TYPE: FD. "X" IN BRIDGE DECK
ON SURFACE - BELOW:
LEFT - CL PAVT - RIGHT: 14.00'

MISC. INFORMATION

POINT IS BETWEEN 5TH AND 6TH GUARDRAIL POST
ON BRIDGE FROM SOUTH AND BETWEEN 8TH AND
9TH GUARDRAIL POST FROM NORTH AND IS 1.58'
WEST OF EAST EDGE OF BRIDGE DECK. SET 1/4" Ø
DRILL HOLE IN CENTER OF "X".



SEPTEMBER 1, 2009

SET 1/4" Ø DRILL HOLE IN
CENTER OF "X"

