

# OTTAWA COUNTY ENGINEERS OFFICE


REFERENCE NO. 30-7-14-B  
 NORTH QUARTER POST SEC. 30  
 BENTON TWP.  
 SHEET 1 OF 1.

ROUTE: T-65 HELLWIG RD.  
 TOWNSHIP: BENTON  
 SECTION: 30  
 T 7 NR 14 E.

PERSONNEL:  
 M. WITTMAN, P.S.  
 J. ALLEN  
 N. ROSE  
 D. MILLER  
 B. ALLEN

NORTHING:  
 EASTING:  
 DATUM:

DATE / WEATHER / TEMP:  
 JULY 25, 2024  
 OVERCAST  
 72° F

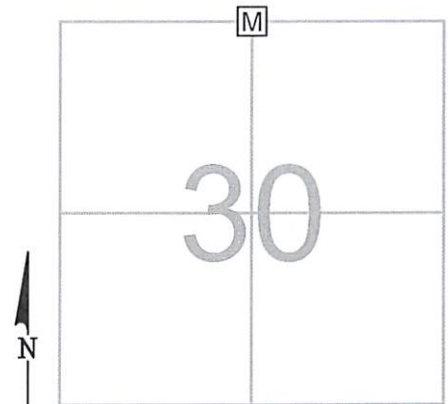

### MONUMENT INFORMATION

MONUMENT TYPE: SET 1" SQ IRON PIN IN MON BOX  
ON SURFACE - BELOW:  
 LEFT - CL PAV'T - RIGHT: 0.50'

JULY 18, 2024 - M.WITTMAN, J. ALLEN, V. SZABO, N. ROSE -  
 ATTEMPT TO LOCATE P.K. NAIL AND/OR STONE PER RECORD  
 SURVEYS WAS MADE WITH NEITHER BEING FOUND.



### MISC. INFORMATION

NO MONUMENTS OF RECORD FOUND ON JULY 18, 2024. POINT  
 WAS CALCULATED USING BEST EVIDENCE FROM SURVEYS ON  
 RECORD IN THE ENGINEER'S OFFICE BY ACCEPTING AND USING  
 THE ANGLE AT THE NE CORNER OF SECTION 30 FROM A  
 SURVEY MADE BY ROBERT A. DORNER, P.S. #6943 IN APRIL 2010  
 AND ACCEPTING AND USING A RECORD DISTANCE FROM A  
 SURVEY BY DAVID A. BRUNKHORST, R.S. #6314 IN APRIL 1985.

JULY 25, 2024

SET 1" SQUARE IRON PIN  
 IN MONUMENT BOX

