

OTTAWA COUNTY ENGINEERS OFFICE

REFERENCE NO. 30-7-14-D
 WEST QUARTER POST SEC. 30
 BENTON TWP.
 SHEET 1 OF 1.

ROUTE: C-213 NISSEN RD.

TOWNSHIP: BENTON

SECTION: 30

T 7 NR 14 E.

PERSONNEL:

M. WITTMAN, P.S.
 J. ALLEN
 E. KOCH
 C. MILLER


NORTHING:

EASTING:

DATE / WEATHER / TEMP:

MAY 21, 2009
 SUNNY W
 74° F

DATUM:

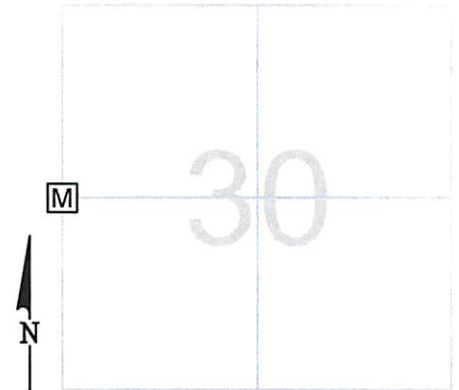

MONUMENT INFORMATION

MONUMENT TYPE: SET 1" SQ. IRON PIN IN MON. BOX
ON SURFACE - BELOW:
 LEFT - CL PAV'T - RIGHT: 1.90'



MISC. INFORMATION

FD. RR SPK ON SURFACE SET BY J. MUSTERIC
 SURVEY DATED 2-7-1997. TIED RR SPK WITH
 CROSS TIES. DUG FOR STONE - NO STONE
 FOUND. CALCULATED AND SET POINT USING
 SINGLE PROPORTIONATE MEASUREMENT. FD
 RR SPK WAS 0.10' SOUTH AND 0.02' WEST OF
 POINT.

THIS IS A CLOSING CORNER

MAY 21, 2009

SET 1" SQUARE IRON PIN
 IN MONUMENT BOX

