

OTTAWA COUNTY ENGINEERS OFFICE

REFERENCE NO. 30-7-14-G
 SW CORNER SECTION 30
 BENTON TWP.
 SHEET 1 OF 1.

ROUTE: C-213 NISSEN RD.

TOWNSHIP: BENTON

SECTION: 30

T 7 NR 14 E.


PERSONNEL:

M. WITTMAN, P.S.
 J. ALLEN

NORTHING:

EASTING:

DATUM:

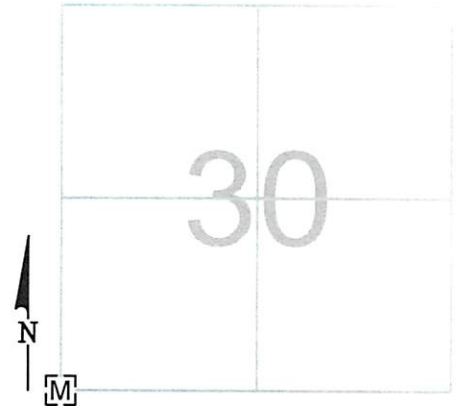

DATE / WEATHER / TEMP:

APRIL 14, 2008
 SUNNY S
 54° F

MONUMENT INFORMATION

MONUMENT TYPE: FD. 1½" Ø IRON PIN W/ DRILL
 HOLE IN MONUMENT BOX
 ON SURFACE - BELOW: 0.21'
 LEFT - CL PAVT - RIGHT:



MISC. INFORMATION

THIS IS A CLOSING CORNER

APRIL 14, 2008

PUT 2" RISER ON TO BRING TO
 SURFACE

